





Re-configuration of 2nd floor

PROJECT

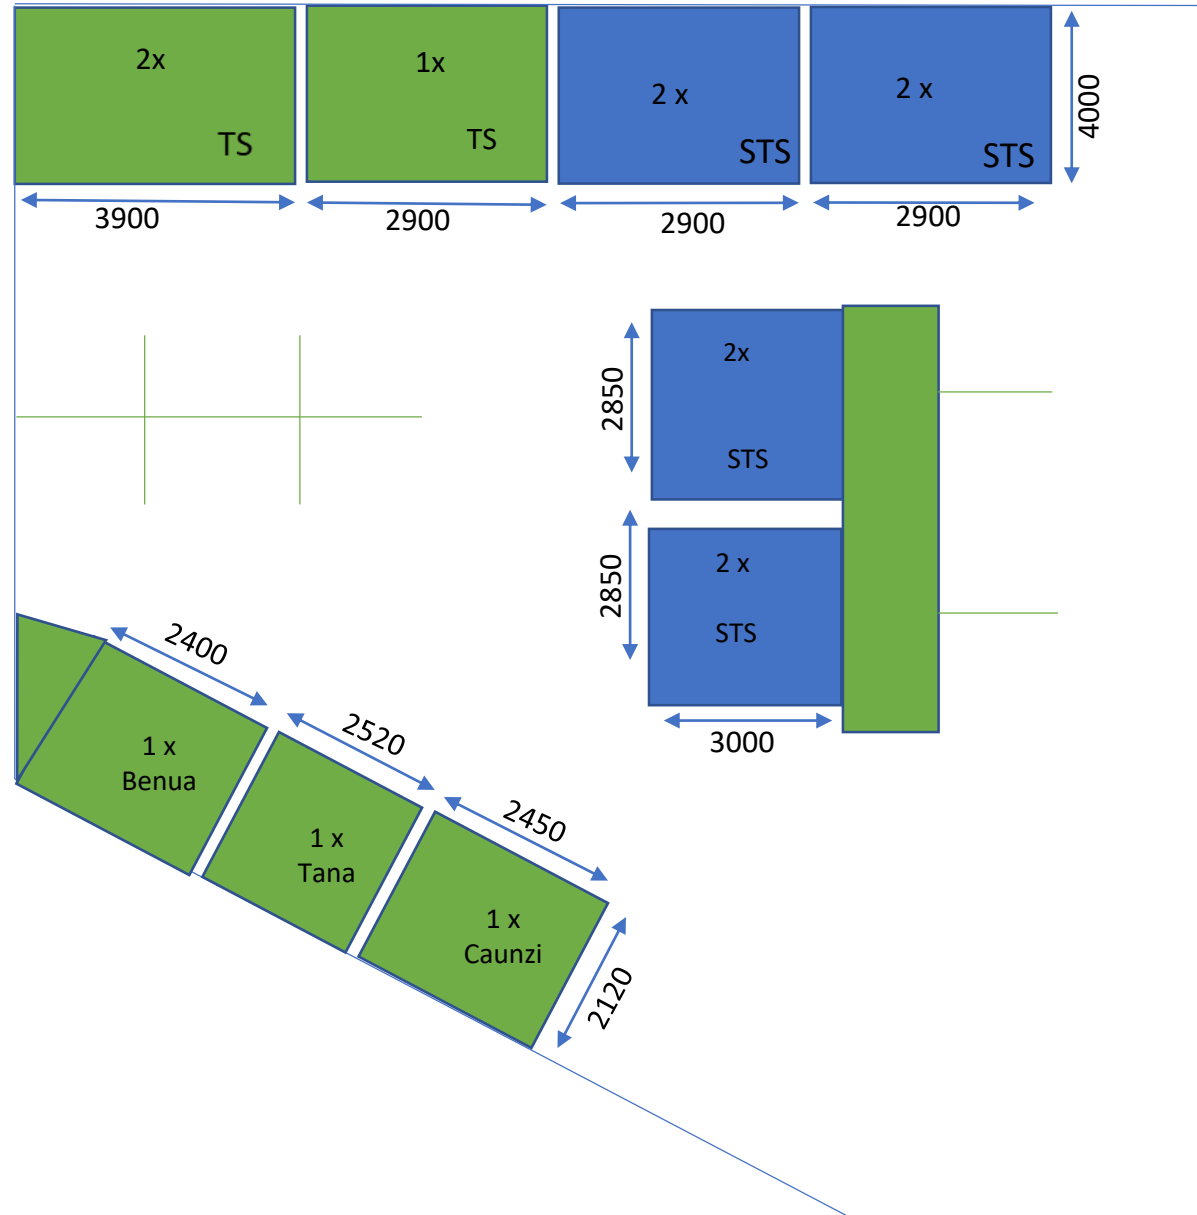

Office between Jay & Shafick

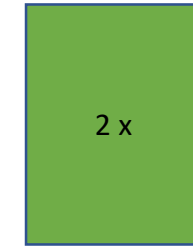

LEGEND

As built	■
To be built	■
1 x	1 Occupant
2 x	2 Occupants
TS	Tight Squeeze
STS	Super Tight Squeeze

Total No of work stations created :16



